


289 N. McDowell Boulevard, Petaluma, California
THE PLAZA NORTH SHOPPING CENTER
1,493 sq.ft

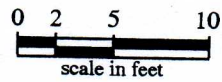

8-10-09